

RESOLUTION NO. R23-27

A RESOLUTION OF THE CITY COUNCIL AUTHORIZING THE MAYOR TO APPROVE A CHANGE ORDER FOR THE PROJECT KNOWN AS THE SOUTH 4TH STREET RECONSTRUCTION.

BE IT RESOLVED by the City Council of the City of Laurel, Montana,

Section 1: Approval. The Change Order for the Project known as the South 4th Street Reconstruction Project, a copy attached hereto and incorporated herein, is hereby approved.

Section 2: Execution. The Mayor is hereby given authority to execute the Change Order for the Project known as the South 4th Street Reconstruction Project on behalf of the City.

Introduced at a regular meeting of the City Council on the 25th day of April, 2023, by Council Member Klose.

PASSED and APPROVED by the City Council of the City of Laurel the 25th day of April, 2023.

APPROVED by the Mayor the 25th day of April, 2023.

CITY OF LAUREL



Dave Waggoner, Mayor

ATTEST:



Kelly Ströcker, Clerk-Treasurer

APPROVED AS TO FORM:



Michele L. Braukmann, Civil City Attorney



Change Order

No. 1

Date of Issuance: 4/14/2023

Effective Date: 4/14/2023

| | | |
|--|------------------------------------|-----------------------|
| Project: South 4 th Street Reconstruction | Owner: City of Laurel | Owner's Contract No.: |
| Contract: | Date of Contract: June 8, 2022 | |
| Contractor: COP Construction | Engineer's Project No.: 2104-00862 | |

The Contract Documents are modified as follows upon execution of this Change Order:

Description:

Contractor is instructed to abandon an existing waterline within Russell Park and replace with an 8" waterline and appurtenances in in South 5th Street between Maple Ave. and Cedar Ave. See the Attached exhibit sheet U-16

Attachments (list documents supporting change): See previously submitted WCD No. 1 and Contractors Copy of Laurel new tie-in Waterline plan & profile between Maple Ave. and Cedar Ave. on South 5th Street – U16

Engineer's Breakout of Change Order Cost

CHANGE IN CONTRACT PRICE:

CHANGE IN CONTRACT TIMES:

Original Contract Price:
\$4,298,070.00

Original Contract Times: Working days Calendar days
Substantial completion (days): 140 Days starting on March. 27, 2023
Ready for final payment (days): 170 Days starting on March 27, 2023

Increase from previously approved Change Orders No. 0
to No. 0:
\$0.00

Increase from previously approved Change Orders
No. 0 to No. 0:
Substantial completion (days): 140 Days starting on March. 27, 2023
Ready for final payment (days): 170 Days after starting on March 27, 2023

Contract Price prior to this Change Order:
\$4,298,070.00


Contract Times prior to this Change Order:
Substantial completion (days): 140 Days starting on March. 27, 2023
Ready for final payment (days): 170 Days starting on March 27, 2023


Increase/Decrease of this Change Order:
\$88,152.36


[Increase] [Decrease] of this Change Order:
Substantial completion (days): 14 Calendar Days
Ready for final payment (days): 14 Calendar Days

Contract Price incorporating this Change Order:
\$4,386,222.36

Contract Times with all approved Change Orders:
Substantial completion (days): 154 Days Starting on March 27,, 2023
Ready for final payment (days): 184 Days starting on March 27, 2023

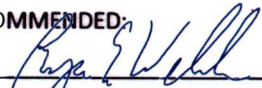RECOMMENDED:
By: 
Engineer (Authorized Signature)
Date: 4/24/2023

ACCEPTED:
By: 
Owner (Authorized Signature)
Date: 4/25/23

ACCEPTED:
By: 
Contractor (Authorized Signature)
Date: 4/25/23



ENGINEER'S BREAKOUT OF CHANGE ORDER COST
2022 Pavement Maintenance Project
S. 4TH ST FROM WEST AVE. TO HWY 212
 City of Laurel, MT
 April 24, 2023






| ITEM | DESCRIPTION | UNIT | QTY | UNIT PRICE | TOTAL PRICE |
|------|--|------|-----|------------|--------------------|
| | Schedule 2 - Water System Improvements | | | | |
| 202 | Taxes, Insurance and Bonds | LS | 1 | \$2,750.00 | \$2,750.00 |
| 203 | Traffic Control | LS | 1 | \$1,300.00 | \$1,300.00 |
| 206 | Temporary Water System, | LS | 1 | \$1,300.00 | \$1,300.00 |
| 208 | Remove Ex. Valve | EA | 2 | \$250.00 | \$500.00 |
| 211 | Remove Ex. Water Main | LF | 20 | \$13.00 | \$260.00 |
| 213 | Connect to Ex. Water Main | EA | 2 | \$2,000.00 | \$4,000.00 |
| 215 | 8" C900 PVC Water Main | LF | 392 | \$78.00 | \$30,576.00 |
| 217 | 8" Gate Valve & Box | EA | 4 | \$4,300.00 | \$17,200.00 |
| 219 | 8" tee | EA | 1 | \$1,700.00 | \$1,700.00 |
| 222 | 8" X 6" Reducer | EA | 2 | \$1,000.00 | \$2,000.00 |
| 224 | 8" Bends | EA | 1 | \$1,400.00 | \$1,400.00 |
| 231 | Install 2" Water Service w/Curb Box | EA | 1 | \$3,300.00 | \$3,300.00 |
| 232 | Install 1" Water Service w/ Curb Box | EA | 1 | \$2,500.00 | \$2,500.00 |
| 233 | 1" Water Service Reconnection | EA | 1 | \$30.00 | \$30.00 |
| 238 | Exploratory Excavation | HR | 4 | \$350.00 | \$1,400.00 |
| 416 | 1-1/2" Crushed Base Course | CY | 145 | \$41.00 | \$5,945.00 |
| 418 | Gravel Alley Surface Repair | SY | 435 | \$14.00 | \$6,090.00 |
| | Unit Price Item Changes | LS | 1 | \$5,901.36 | \$5,901.36 |
| | Total Change Order Cost | | | | \$88,152.36 |



| | |
|----------------|------------|
| REVISION | |
| DATE | |
| DWGT | MK |
| REVISED | RW |
| PROJECT NUMBER | 2104-00862 |
| ISSUE DATE | 04/14/2023 |

SOUTH 4TH STREET RECONSTRUCTION
 CITY OF LAUREL
 LAUREL, MT

SHEET
 U16

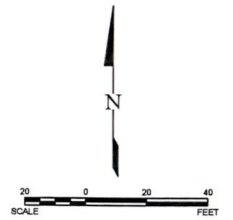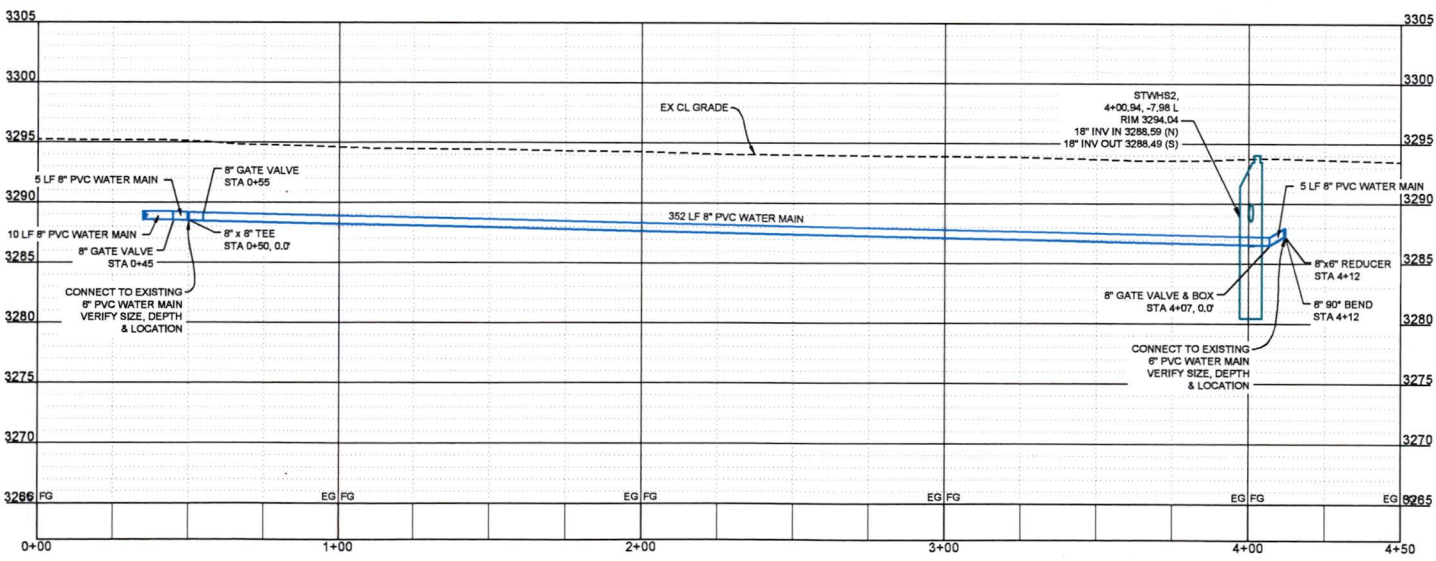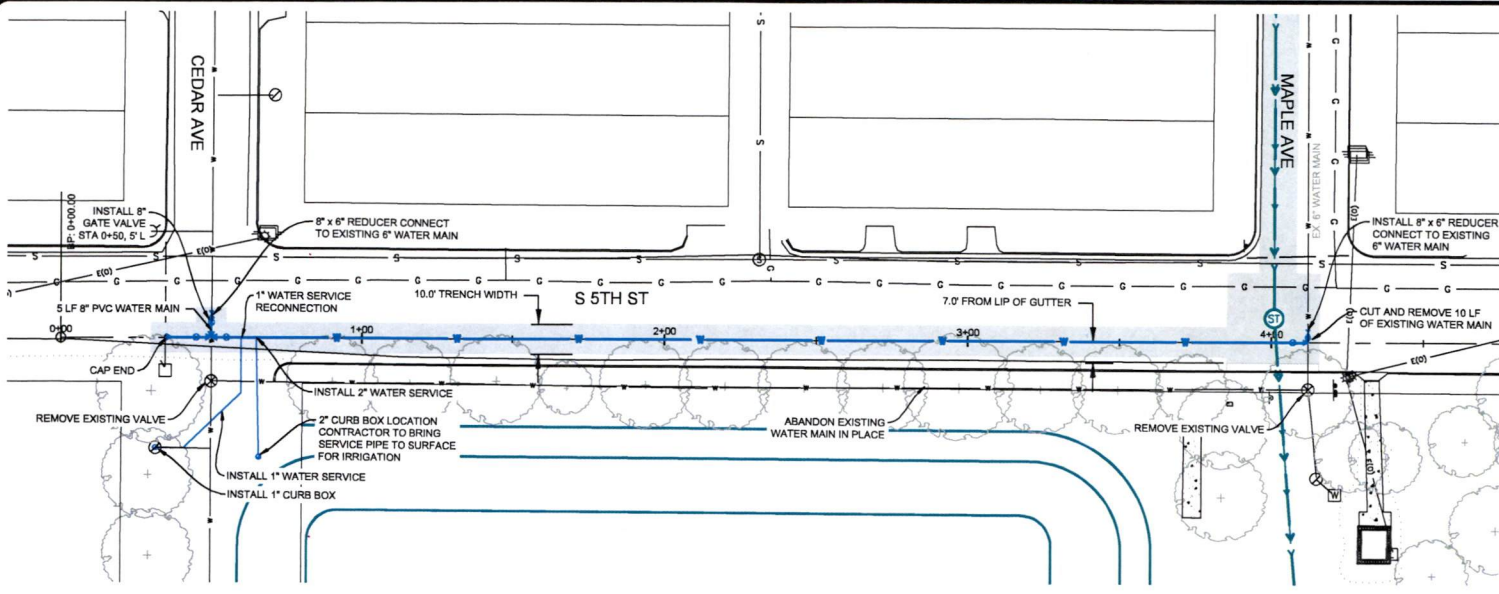

Apr 14, 2023 - 5:13pm - K:\Projects\City\MT\Laurel\2104_00862_2022_Pavement\Maintenance\CAD\AsBuilt\U - Plan-Profile.dwg (U16)